
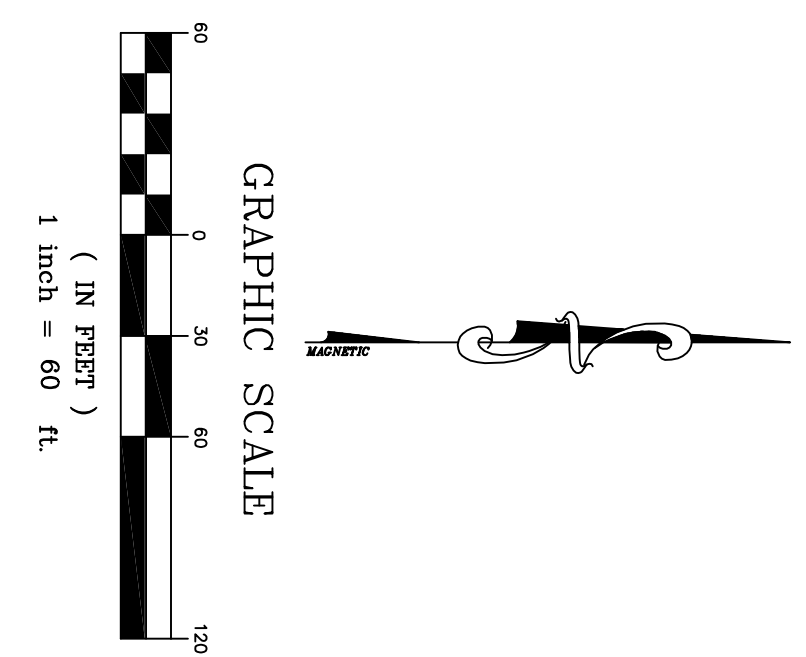


- LEGEND
- WP WOOD POST
 - FW FIRE HYDRANT
 - SM STEIN MANHOLE
 - LP LAMP POLE
 - ZSD 2" Z" STORM DRAIN
 - 4SD 4" 4" STORM DRAIN
 - EB ELECTRIC BOX
 - PB PHONE BOX
 - CB CLEAN OUT
 - PP POWER POLE
 - WM WATER METER
 - WCO WATER CUT OFF
 - BKG BASKETBALL GOAL
 - MW MUD WALL
 - RW RETAINING WALL
 - PA PAVEMENT

I HEREBY CERTIFY THAT THIS IS A CATEGORY 1 SURVEY AND THE PLANO OF PRECISION OF THE UNADJUSTED SURVEY IS 1:10,000 AS SHOWN HEREON.

ALFRED W. BARTLETT
 TENNESSEE REGISTRATION NO. #192
 DATE OF SURVEY _____

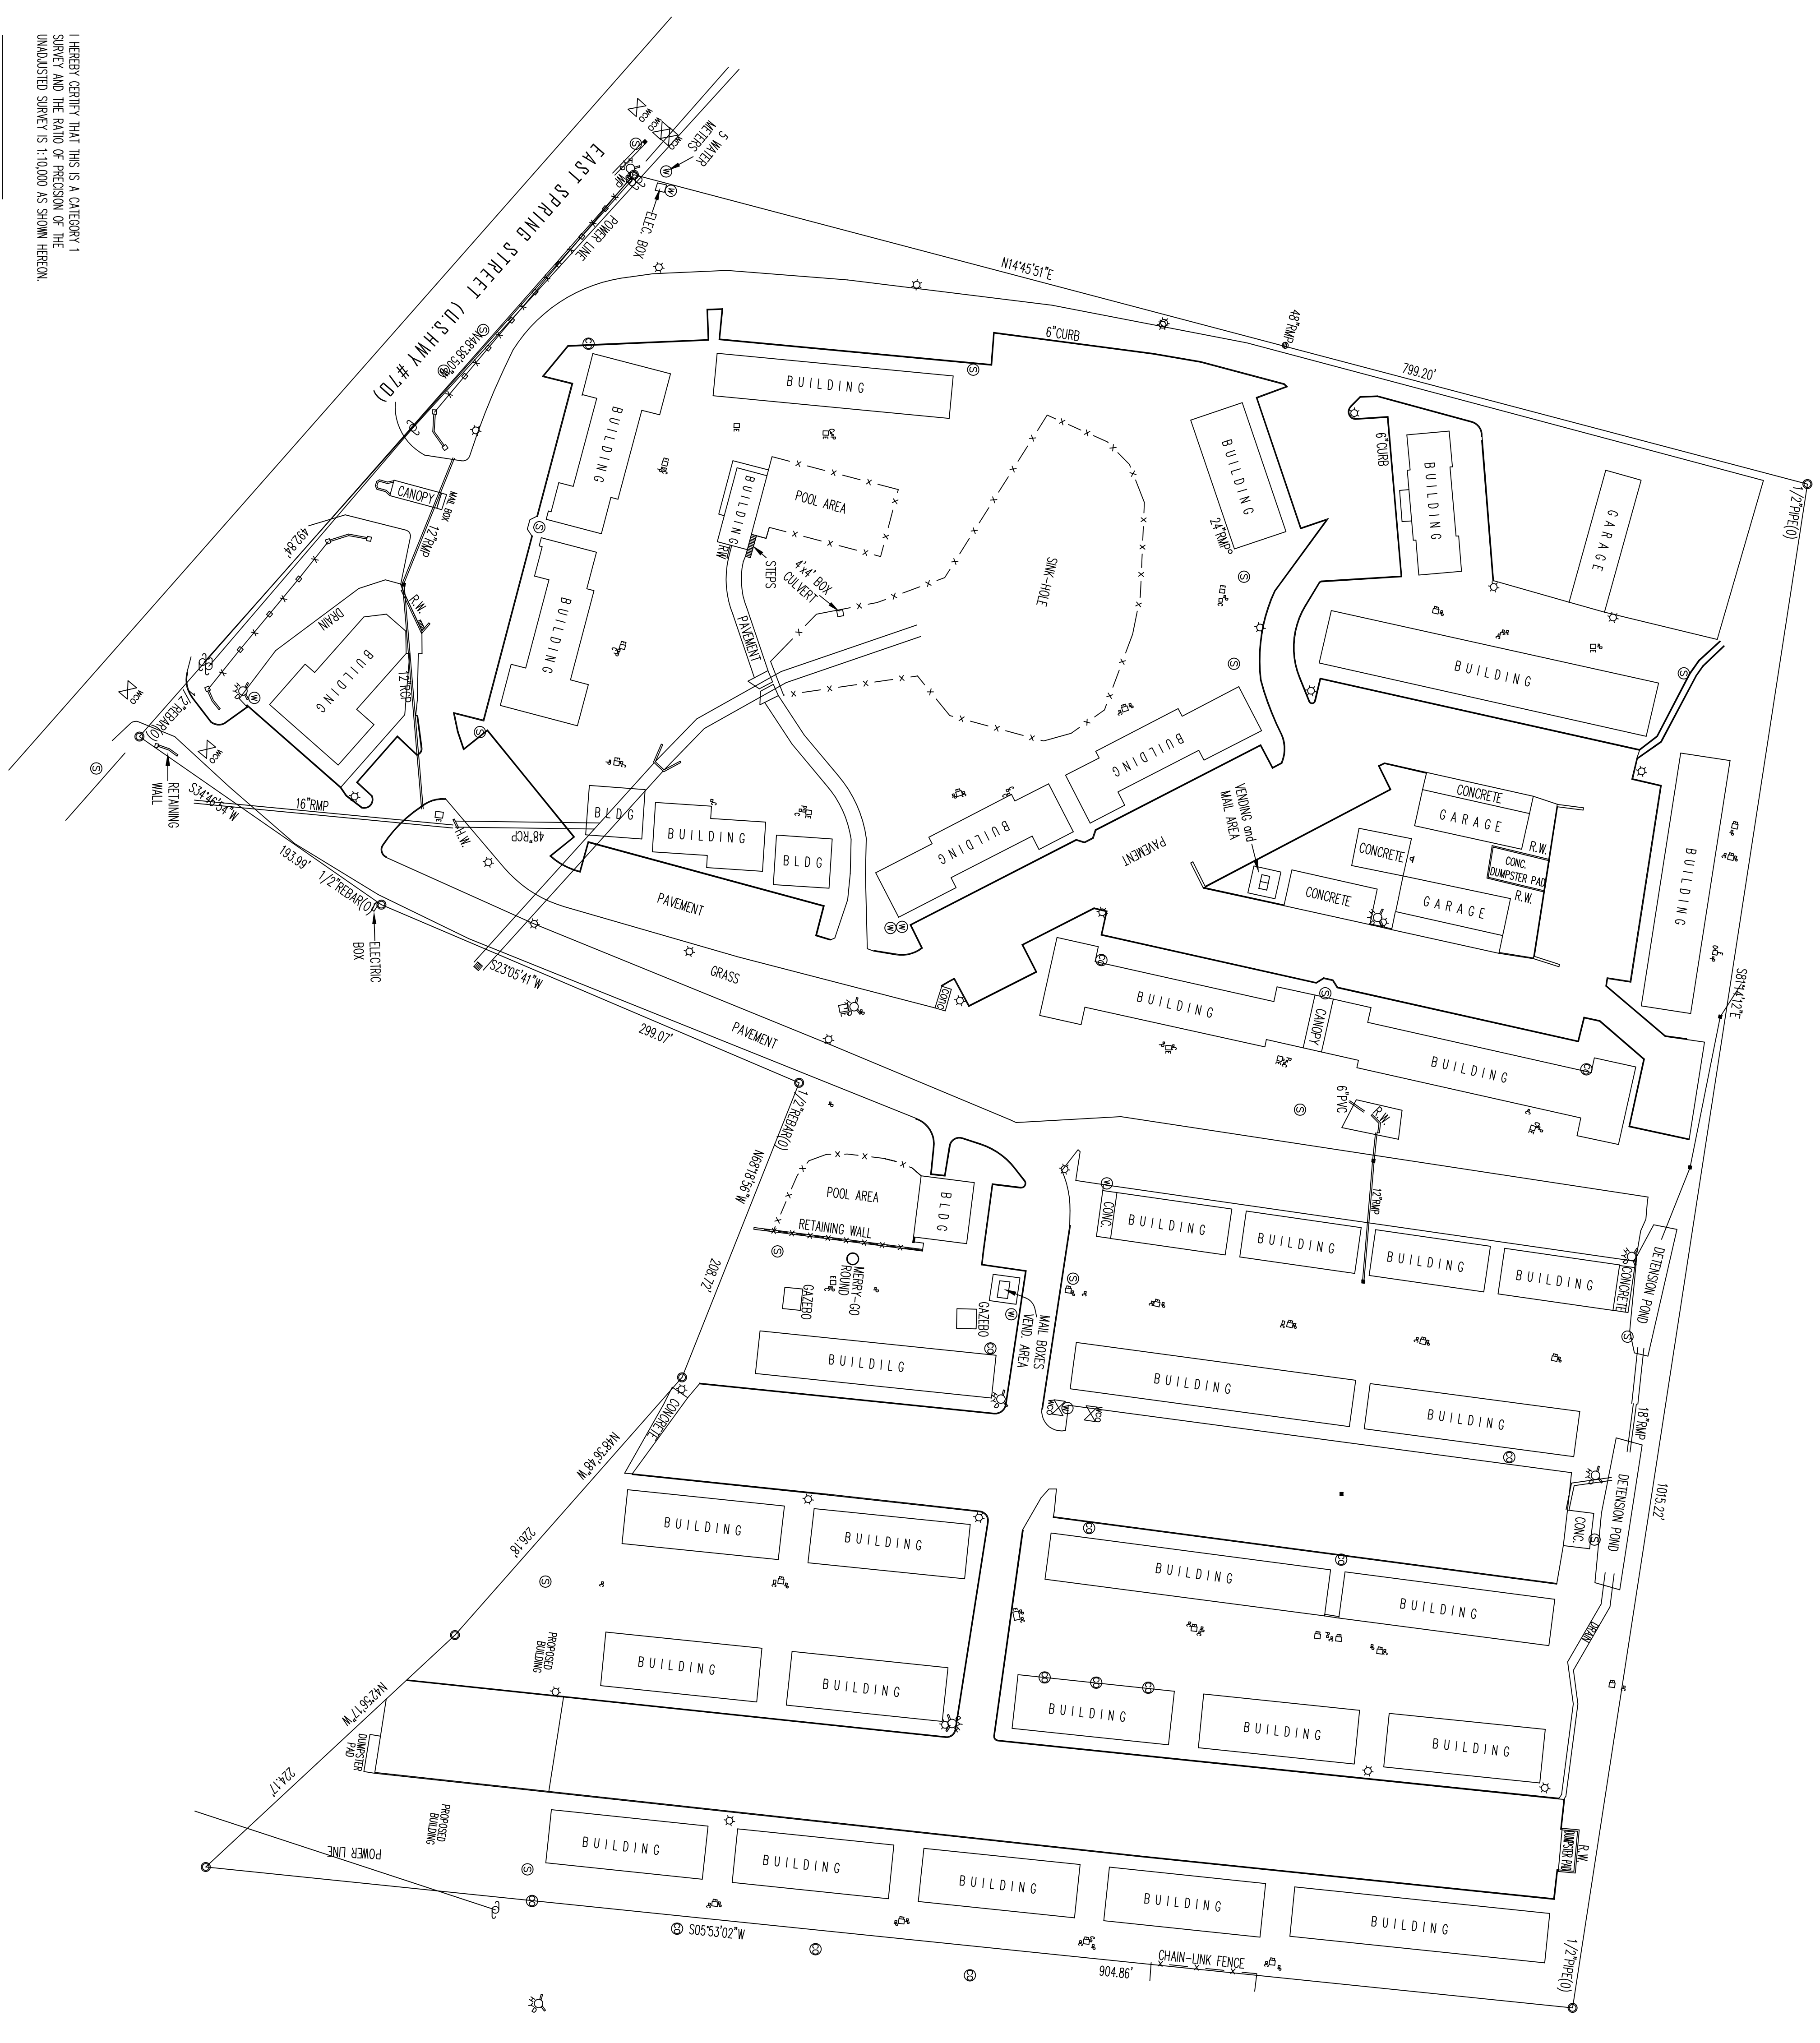

Bartlett Surveying

214 East Stevens Street - Cookeville, TN 38501
 Phone: (615) 226-0000 Fax: (615) 226-7799

ASBUILT SURVEY FOR
Saxony Apartments

1st COUN. DISTRICT	TOTAL ACRES: 20.1114
PULASKI COUNTY, TN	SCALE: 1"=60'
MAP 53, PAR 17.703	DATE: 6/8/2004
P and T BR-442 PG-335	DRAWING #A-182 E